


**LEGEND**

- Centre-line of Bitumen
- ⚡ Flushing Point
- Stormwater Pit
- - - Toe of Bank
- Top of Bank
- - - U/G Drain
- Outlet 100mm PVC in Kerb

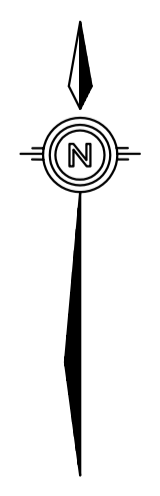

**PRINCIPAL**  
**Housing Development**

**PROJECT**  
**AS CONSTRUCTED INFORMATION**  
 Balony Subdivision  
 Stage 1  
**ROAD & DRAINAGE**

**REAL PROPERTY DESCRIPTION**  
 Lot No's: 40 - 62  
 Plan: SP174124  
 Orig. Por: 103  
 Parish: EAST STOWE  
 County: Calliope  
 L.A.: Calliope S.C.  
 Zone: Residential

REVISIONS	DATE	INITS

SOURCE DATA	FILE REF:	G2594-44
	VERSION:	
SURVEY	DATA DISK:	
	DATE:	12-02-2005
DRAFTING	FILE REF:	G2594-DRAINAGE
	DATE:	16-02-2005

**SURVEYED:** J.W.R.

**DRAWN:** MCS Drafting

**QUALITY CH'D:** J.W.R.

**DATE:**

DATUM	HORIZONTAL	GDA
	VERTICAL	AHD

**SCALE**  
**1 : 400 @ A 1**  
 0 5 10 15 20 25 30

**AUTHORISED BY**  **DATE**

**DIRECTOR AND CADASTRAL SURVEYOR**  
**JOB NO.**  **REVISION**

**DRAINAGE**