




HIGHWAY

LEGEND

⊙	Brass Plug in Conc
×	Light Pole
*	Power Turret
—E—	U/G Elec Conduit

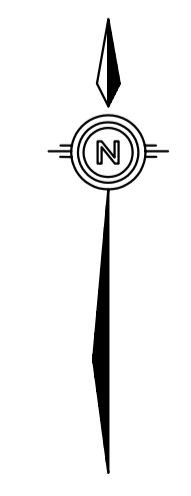

PRINCIPAL
Central Qld
Housing
Development

PROJECT
AS CONSTRUCTED
INFORMATION
Silverdale Subdivision
Stage 1
ELECTRICITY

REAL PROPERTY DESCRIPTION
Lot No's: 40 - 62
Plan: SP174124
Orig. Por: 103
Parish: EAST STOWE
County: Calliope
L.A.: Calliope S.C.
Zone: Residential

REVISIONS	DATE	INITS

SOURCE DATA	FILE REF:	G2594-44
	VERSION:	?
	DATA DISK:	?
	DATE:	12-02-2005
DRAFTING	FILE REF:	G2594-ELECTRICITY
	DATA DISK:	?
	DATE:	16-02-2005

SURVEYED: J.W.R.


DRAWN: MCS Drafting

QUALITY CH'D: J.W.R.

DATE:

DATUM	HORIZONTAL	GDA
	VERTICAL	AHD

SCALE
1:400 @ A1

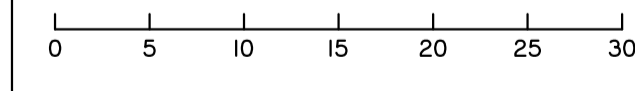

AUTHORISED BY _____ DATE _____

DIRECTOR AND CADASTRAL SURVEYOR

JOB NO. _____ REVISION _____

G2594-Stage1