


HIGHWAY

LEGEND

◆	Brass Marker in Kerb
■	Fire Hydrant
⊗	Stop Valve
—	Water Main

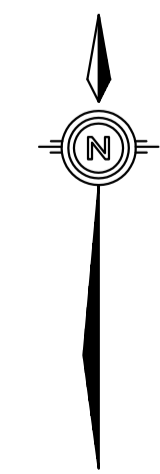

PRINCIPAL
Housing Development

PROJECT
AS CONSTRUCTED INFORMATION
Balony Subdivision
Stage 1
WATER RETICULATION

REAL PROPERTY DESCRIPTION
Lot No's: 40 - 62
Plan: SP174124
Orig. Por: 103
Parish: EAST STOWE
County: Calliope
L.A.: Calliope S.C.
Zone: Residential

REVISIONS	DATE	INITS

SOURCE DATA SURVEY	FILE REF: G2594-44
	VERSION:
DRAFTING	DATA DISK:
	DATE: 12-02-2005
DRAFTING	FILE REF: G2594-WATER
	DATE: 16-02-2005

SURVEYED: J.W.R.
DRAWN: MCS Drafting
QUALITY CH'D: J.W.R.
DATE:

HORIZONTAL
GDA
VERTICAL
AHD

SCALE
1:400 @ A1
0 5 10 15 20 25 30

AUTHORISED BY DATE
DIRECTOR AND CADASTRAL SURVEYOR
JOB NO. REVISION

WATER